




DETAILED PLAN

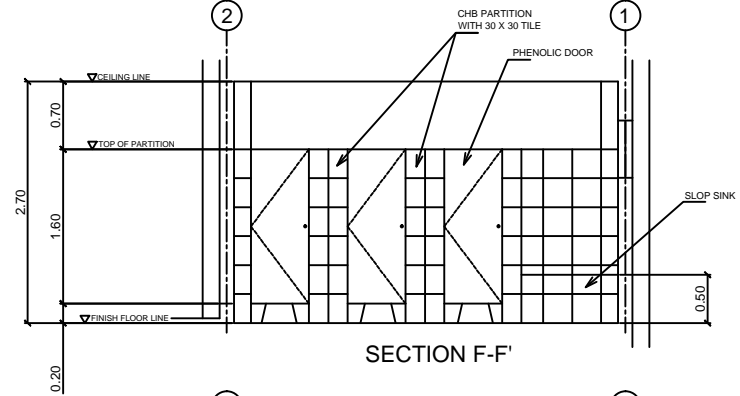

SECTION F-F'

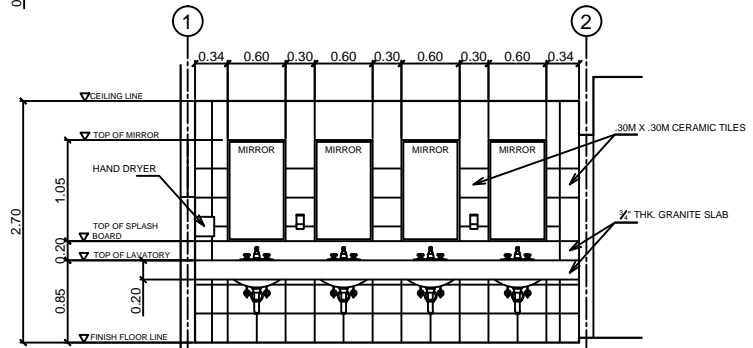


SECTION G-G'

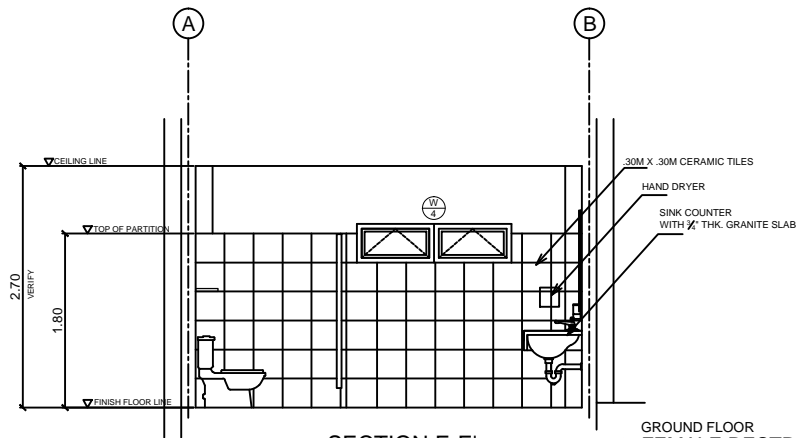

SECTION E-E'

GROUND FLOOR  
FEMALE RESTROOM DETAILS  
SCALE: 1:30 M

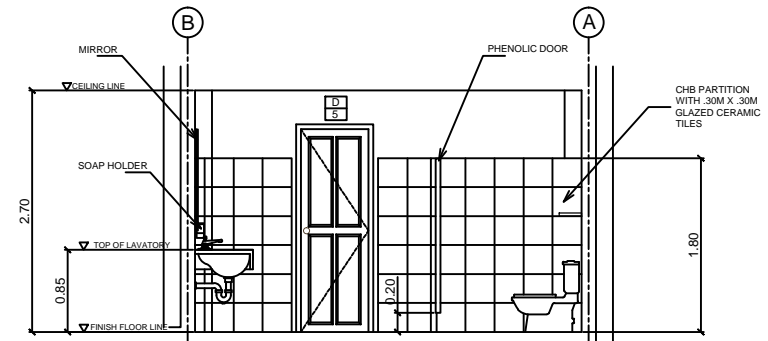

SECTION H-H'



**TOPSTEEL BUILDERS**  
1-C EVANGELISTA ST. BATANGAS CITY  
043- 980-8888/043- 723-2534 Fax No. 043- 723-3480

ARCHITECT/CIVIL ENGINEER			SEAL
_____			
PRC Reg No.	Valid until:	TIN:	
PTR No.	Issued on:	Issued at:	

PROJECT / LOCATION:	OWNER
FIVE STOREY BATSTATEU CIT BUILDING	BATANGAS STATE UNIVERSITY
BatStateU Alangilan Campus	DR. TIRSO A. RONQUILLO
Golden Country, Alangilan, Batangas City	UNIVERSITY PRESIDENT

DESIGNED:	
DRAWN/CAD:	
CHECKED:	
DATE:	

AS-BUILT PLAN

SHEET CONTENT	SHEET NO.
FEMALE RESTROOM DETAILS: DETAILED PLAN SECTIONS	<b>A</b> 22/25