




SECTION THROUGH B-B  
SCALE: 1:100 M

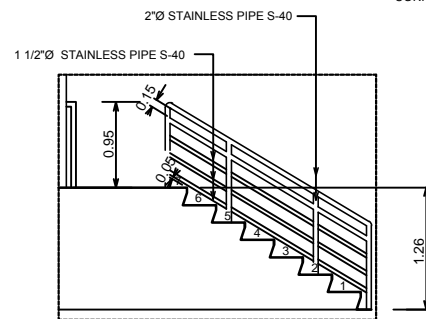


SPOT DETAIL "A"  
SCALE: 1:30 M

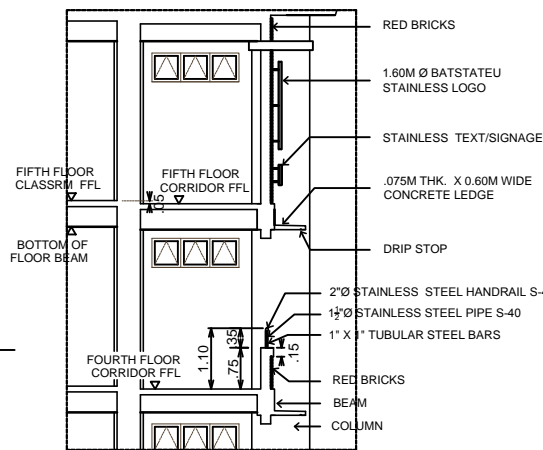


SPOT DETAIL "B"  
SCALE: 1:50 M

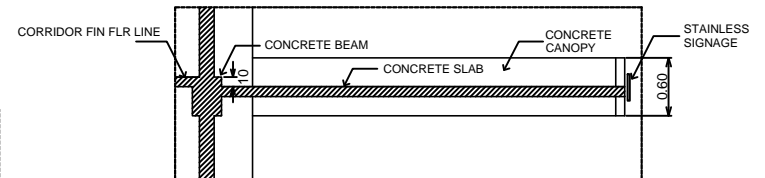

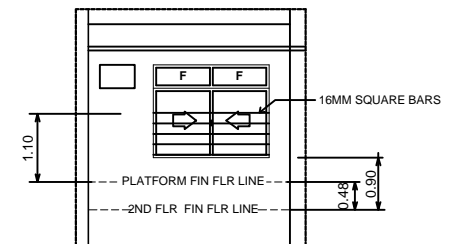

SPOT DETAIL "C"  
SCALE: 1:30 M

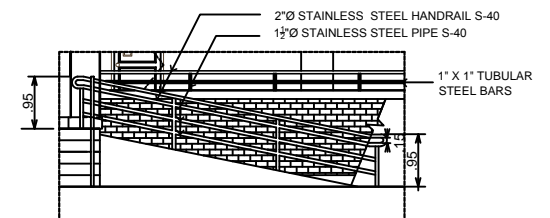

REAR ELEVATION's  
SPOT DETAIL "D"  
SCALE: 1:50 M



RAMP FOR PWD  
DETAILS  
SCALE: 1:50 M

 <b>TOPSTEEL BUILDERS</b> 1-C EYANGELISTA ST. BATANGAS CITY 043- 980-8888/043- 723-2534 Fax No. 043- 723-3480	ARCHITECT/CIVIL ENGINEER	SEAL	PROJECT / LOCATION:	OWNER	DESIGNED:	AS-BUILT PLAN	SHEET CONTENT	SHEET NO.
			FIVE STOREY BATSTATEU CIT BUILDING	BATANGAS STATE UNIVERSITY			SECTION THROUGH B-B	
	PRC Reg No.	Valid until:	BatStateU Alangilan Campus	DR. TIRSO A. RONQUILLO	DRAWN/CAD:			
	PTR No.	Issued on:	Golden Country, Alangilan, Batangas City	UNIVERSITY PRESIDENT	CHECKED:			
					DATE:			