




GROUND FLOOR PLAN  
SCALE 1:100 M

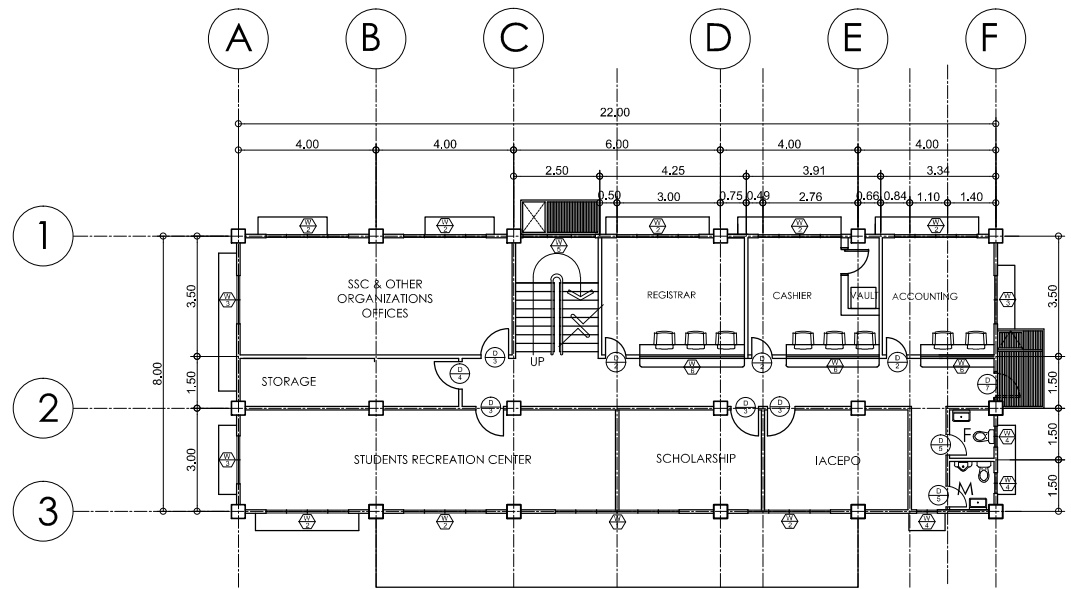

SECOND FLOOR PLAN  
SCALE 1:100 M

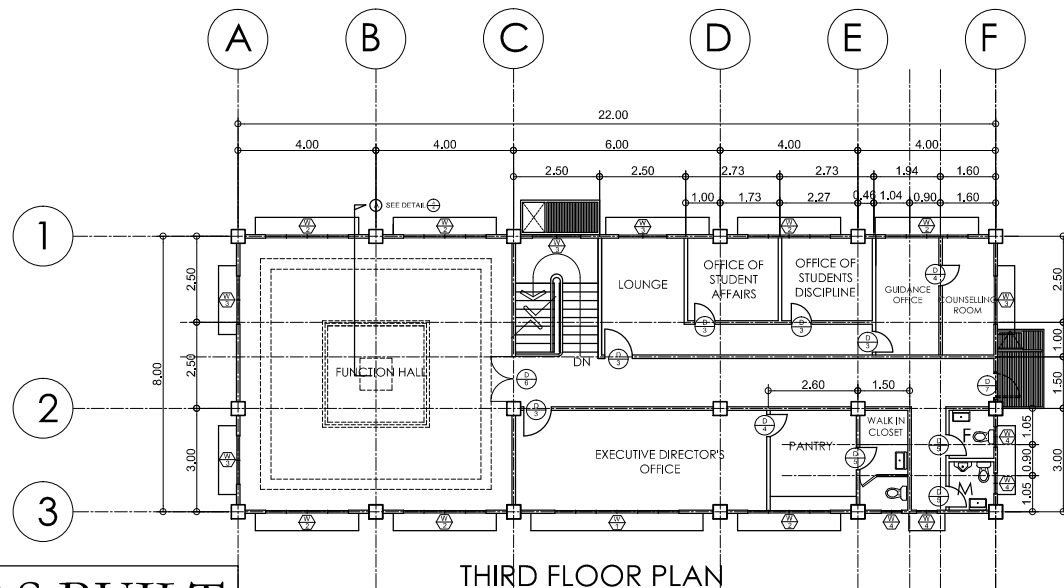

THIRD FLOOR PLAN  
SCALE 1:100 M

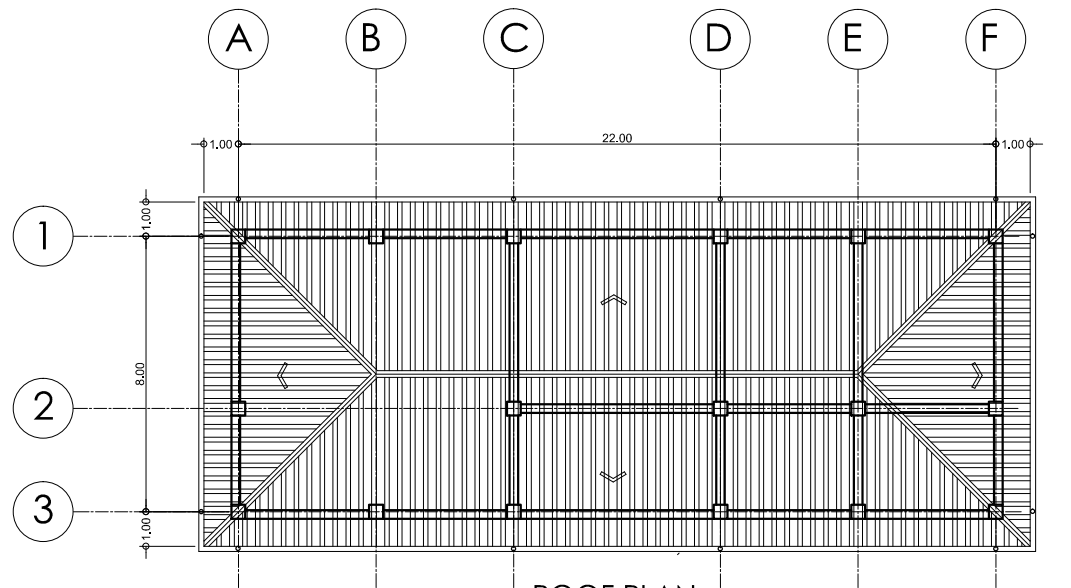

ROOF PLAN  
SCALE 1:100 M

AS BUILT  
AS OF 11-08-12



**BatStateU**  
BATANGAS STATE UNIVERSITY  
Gov. Pablo Borbon Main Campus I  
Rizal Avenue Extension, Batangas City  
SPECIAL PROJECTS OFFICE

ARCHITECT/CIVIL ENGINEER  
ENGR. CHESTER ALLAN M. TORRES  
PRC No.: 0114406  
IAPOA No.:  
PTR No.: 1680421 DATE: 01/02/2012  
PLACE: BATANGAS TIN: 290-037-494

CONTRACTOR:  
C:\Users\pc\Desktop\wmlc.jpg

PROJECT / LOCATION:  
PROPOSED THREE STOREY STUDENT  
SERVICES CENTER BUILDING  
MAIN CAMPUS II  
GOLDEN COUNTRY SUBD., ALANGILAN

OWNER  
BATANGAS STATE UNIVERSITY  
DR. TIRSO A. RONQUILLO  
UNIVERSITY PRESIDENT

DESIGNED:  
DRAWN/CAD: L.UMALI/ECAT  
CHECKED:  
DATE:

No.	REVISIONS	DATE

SHEET CONTENT  
AS SHOWN  
SHEET no.  
A  
2