

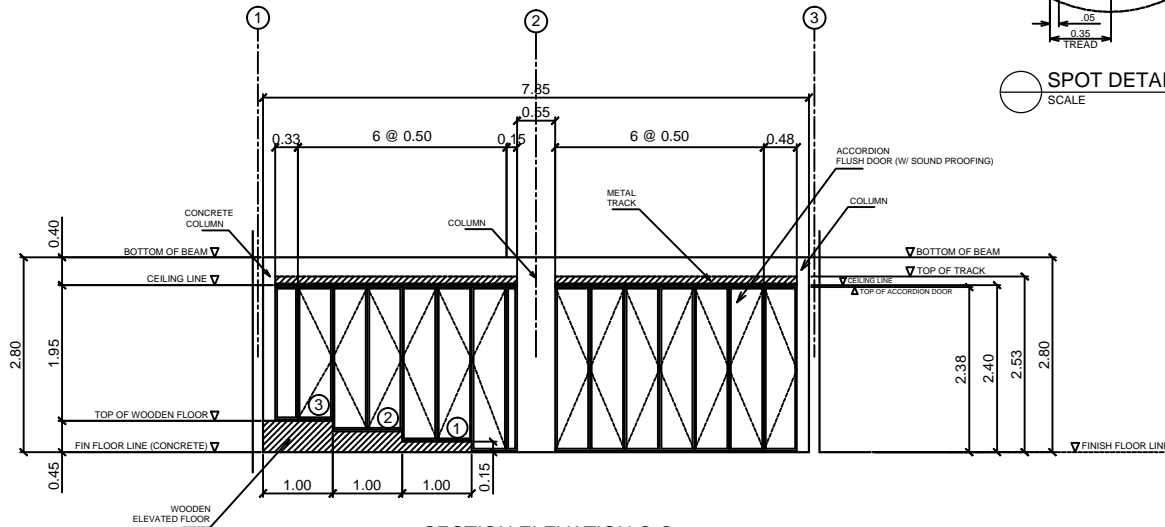


SPOT DETAIL "A"
SCALE 1:15 M

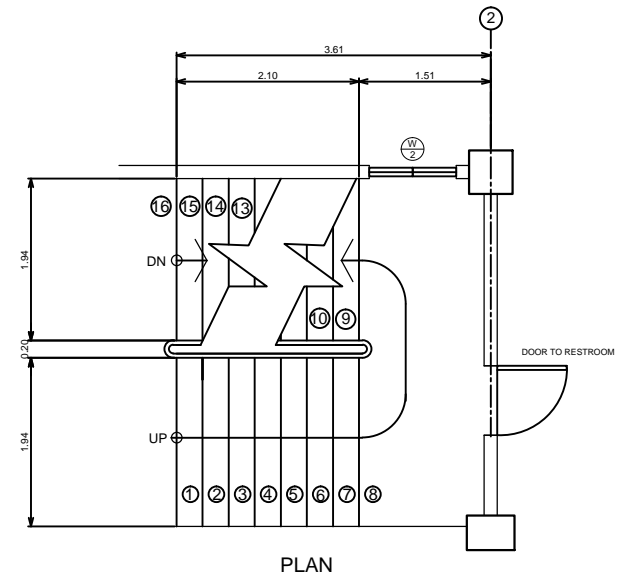

MULTIMEDIA ROOM
ACCORDION DOOR DETAILS
SCALE 1:50 M

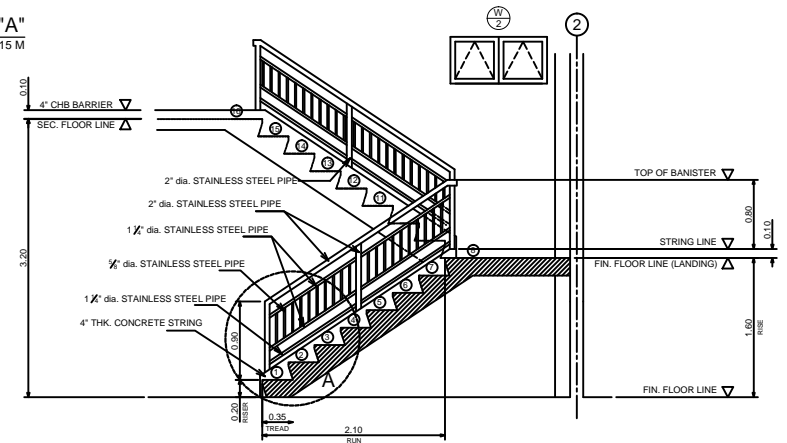

STAIR DETAILS
SCALE 1:30 M



TOPSTEEL BUILDERS
1-C EVANGELISTA ST. BATANGAS CITY
(043- 980-8888/(043- 723-2534 Fax No. (043- 723-3480)

ARCHITECT/CIVIL ENGINEER	SEAL	PROJECT / LOCATION:	OWNER	DESIGNED:	AS-BUILT PLAN	SHEET CONTENT	SHEET NO.
		FIVE STOREY BATSTATEU CIT BUILDING	BATANGAS STATE UNIVERSITY	DRAWN/CAD:		ACCORDION DOOR DETAILS	A 25/25
PRC Reg No.	Valid until:	BatStateU Alangilan Campus	DR. TIRSO A. RONQUILLO	CHECKED:		STAIR DETAILS	
PTR No.	Issued on:	Golden Country, Alangilan, Batangas City	UNIVERSITY PRESIDENT	DATE:			