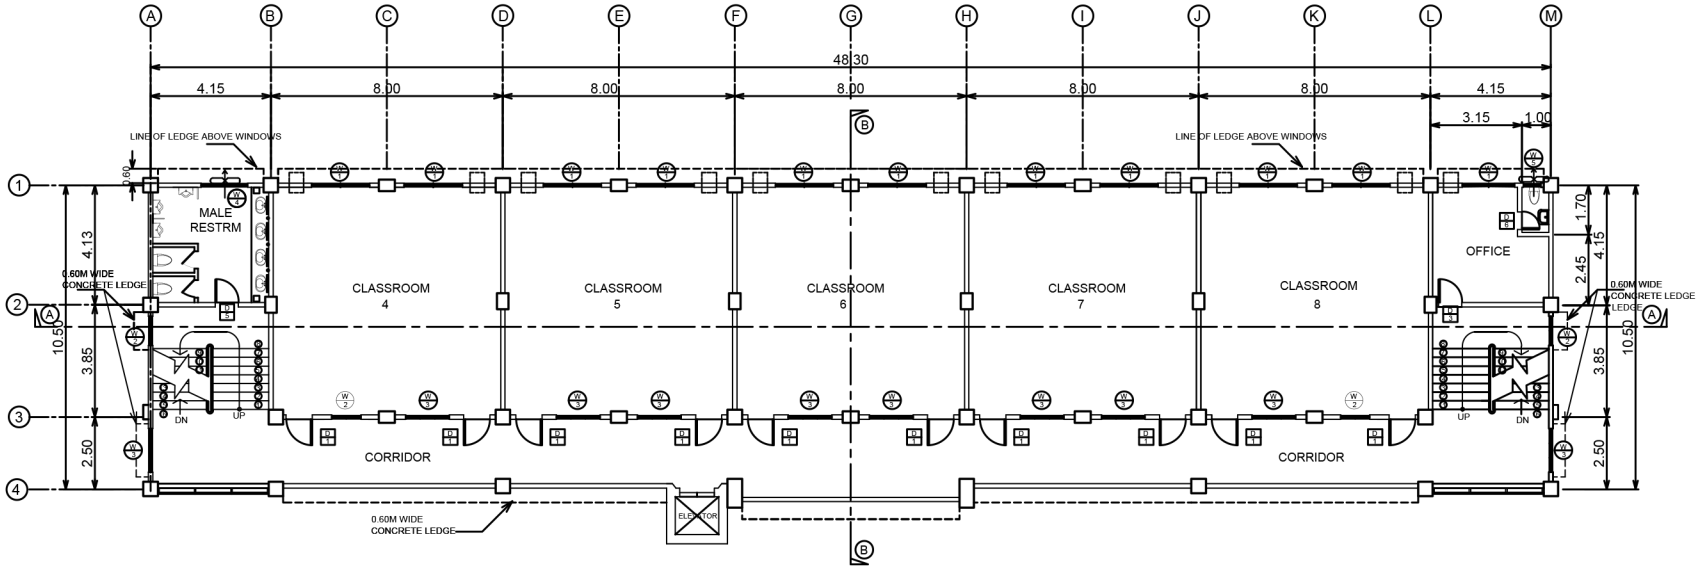

FOURTH FLOOR PLAN

SCALE: 1:100 M

TOPSTEEL BUILDERS 1-C EVANGELISTA ST. BATANGAS CITY 043- 980-8888/043- 723-2554 Fax No. 043- 723-3480	ARCHITECT/CIVIL ENGINEER PRC Reg No. / Valid until: / TIN: PTR No. / Issued on: / Issued at:	SEAL	PROJECT / LOCATION: FIVE STOREY BATSTATEU CIT BUILDING BatStateU Alangilan Campus Golden Country, Alangilan, Batangas City	OWNER BATANGAS STATE UNIVERSITY DR. TIRSO A. RONQUILLO UNIVERSITY PRESIDENT	DESIGNED: DRAWN/CAD: CHECKED: DATE:	AS-BUILT PLAN	SHEET CONTENT: FOURTH FLOOR PLAN SHEET NO.: A 6/25